



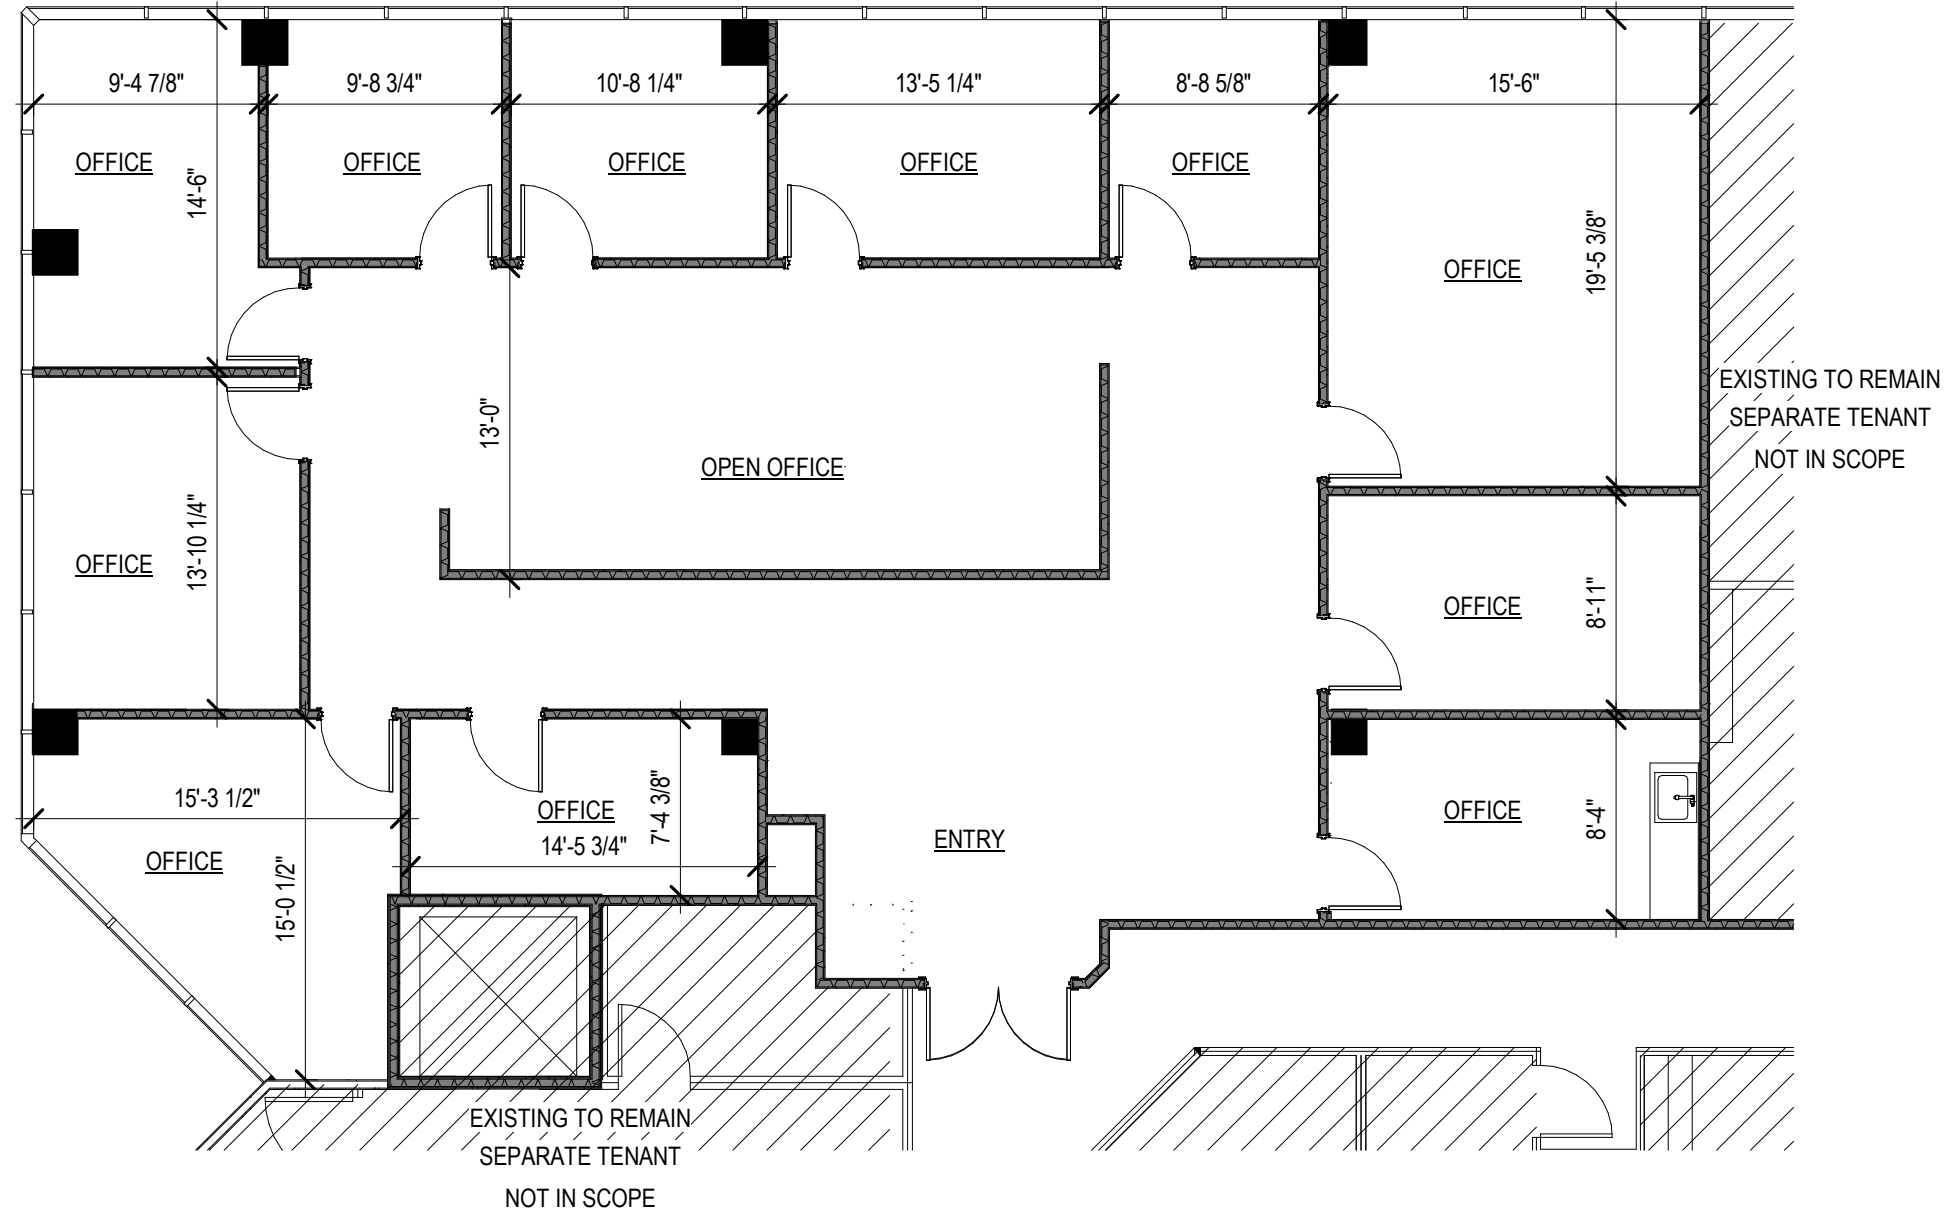

NOT FOR BIDDING OR CONSTRUCTION

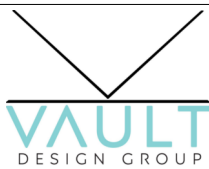

2600 MCP - SUITE 130

SPACEPLAN

2600 MAITLAND CENTER PARKWAY
MAITLAND, FL 32751

SPACEPLAN

DATE: 07/24/2026

PROJECT MANAGER: KG, CD

SP-01

PROJECT NO: EM-011_1ST